

1:9
ARCHITECTURE

1511 E. ORANGETHORPE AVE,
SUITE C FULLERTON, CA 92831

© 1:9 ARCHITECTURE, A CALIFORNIA CORPORATION. ALL
DRAWINGS AND WRITTEN MATERIAL HEREIN CONSTITUTE THE
ORIGINAL AND UNPUBLISHED WORK OF THE ARCHITECT, AND
THE SAME MAY NOT BE DUPLICATED, USED, OR DISCLOSED
WITHOUT THE WRITTEN CONSENT OF THE ARCHITECT.

ARCHITECT



CLIENT/PROJECT LOCATION

TARSUS

17700 LAGUNA CANYON RD
SUITE 300 AND SUITE 400
IRVINE, CA 92618




DELTA	REVISION	DESCRIPTION	DATE
1		ISSUED FOR PLAN CHECK	05/09/2025
2		REISSUED FOR PLAN CHECK	06/20/2025
3		REISSUED FOR PLAN CHECK	07/17/2025
4		REISSUED FOR PLAN CHECK	08/04/2025
5		REVISION TO PERMIT	09/29/2025

DRAWN: DG CHECK: CP SCALE: 1/8"=1'-0"

JOB NO:

TITLE: THIRD FLOOR -
PARTITION PLAN

SHEET:
3A-1.0

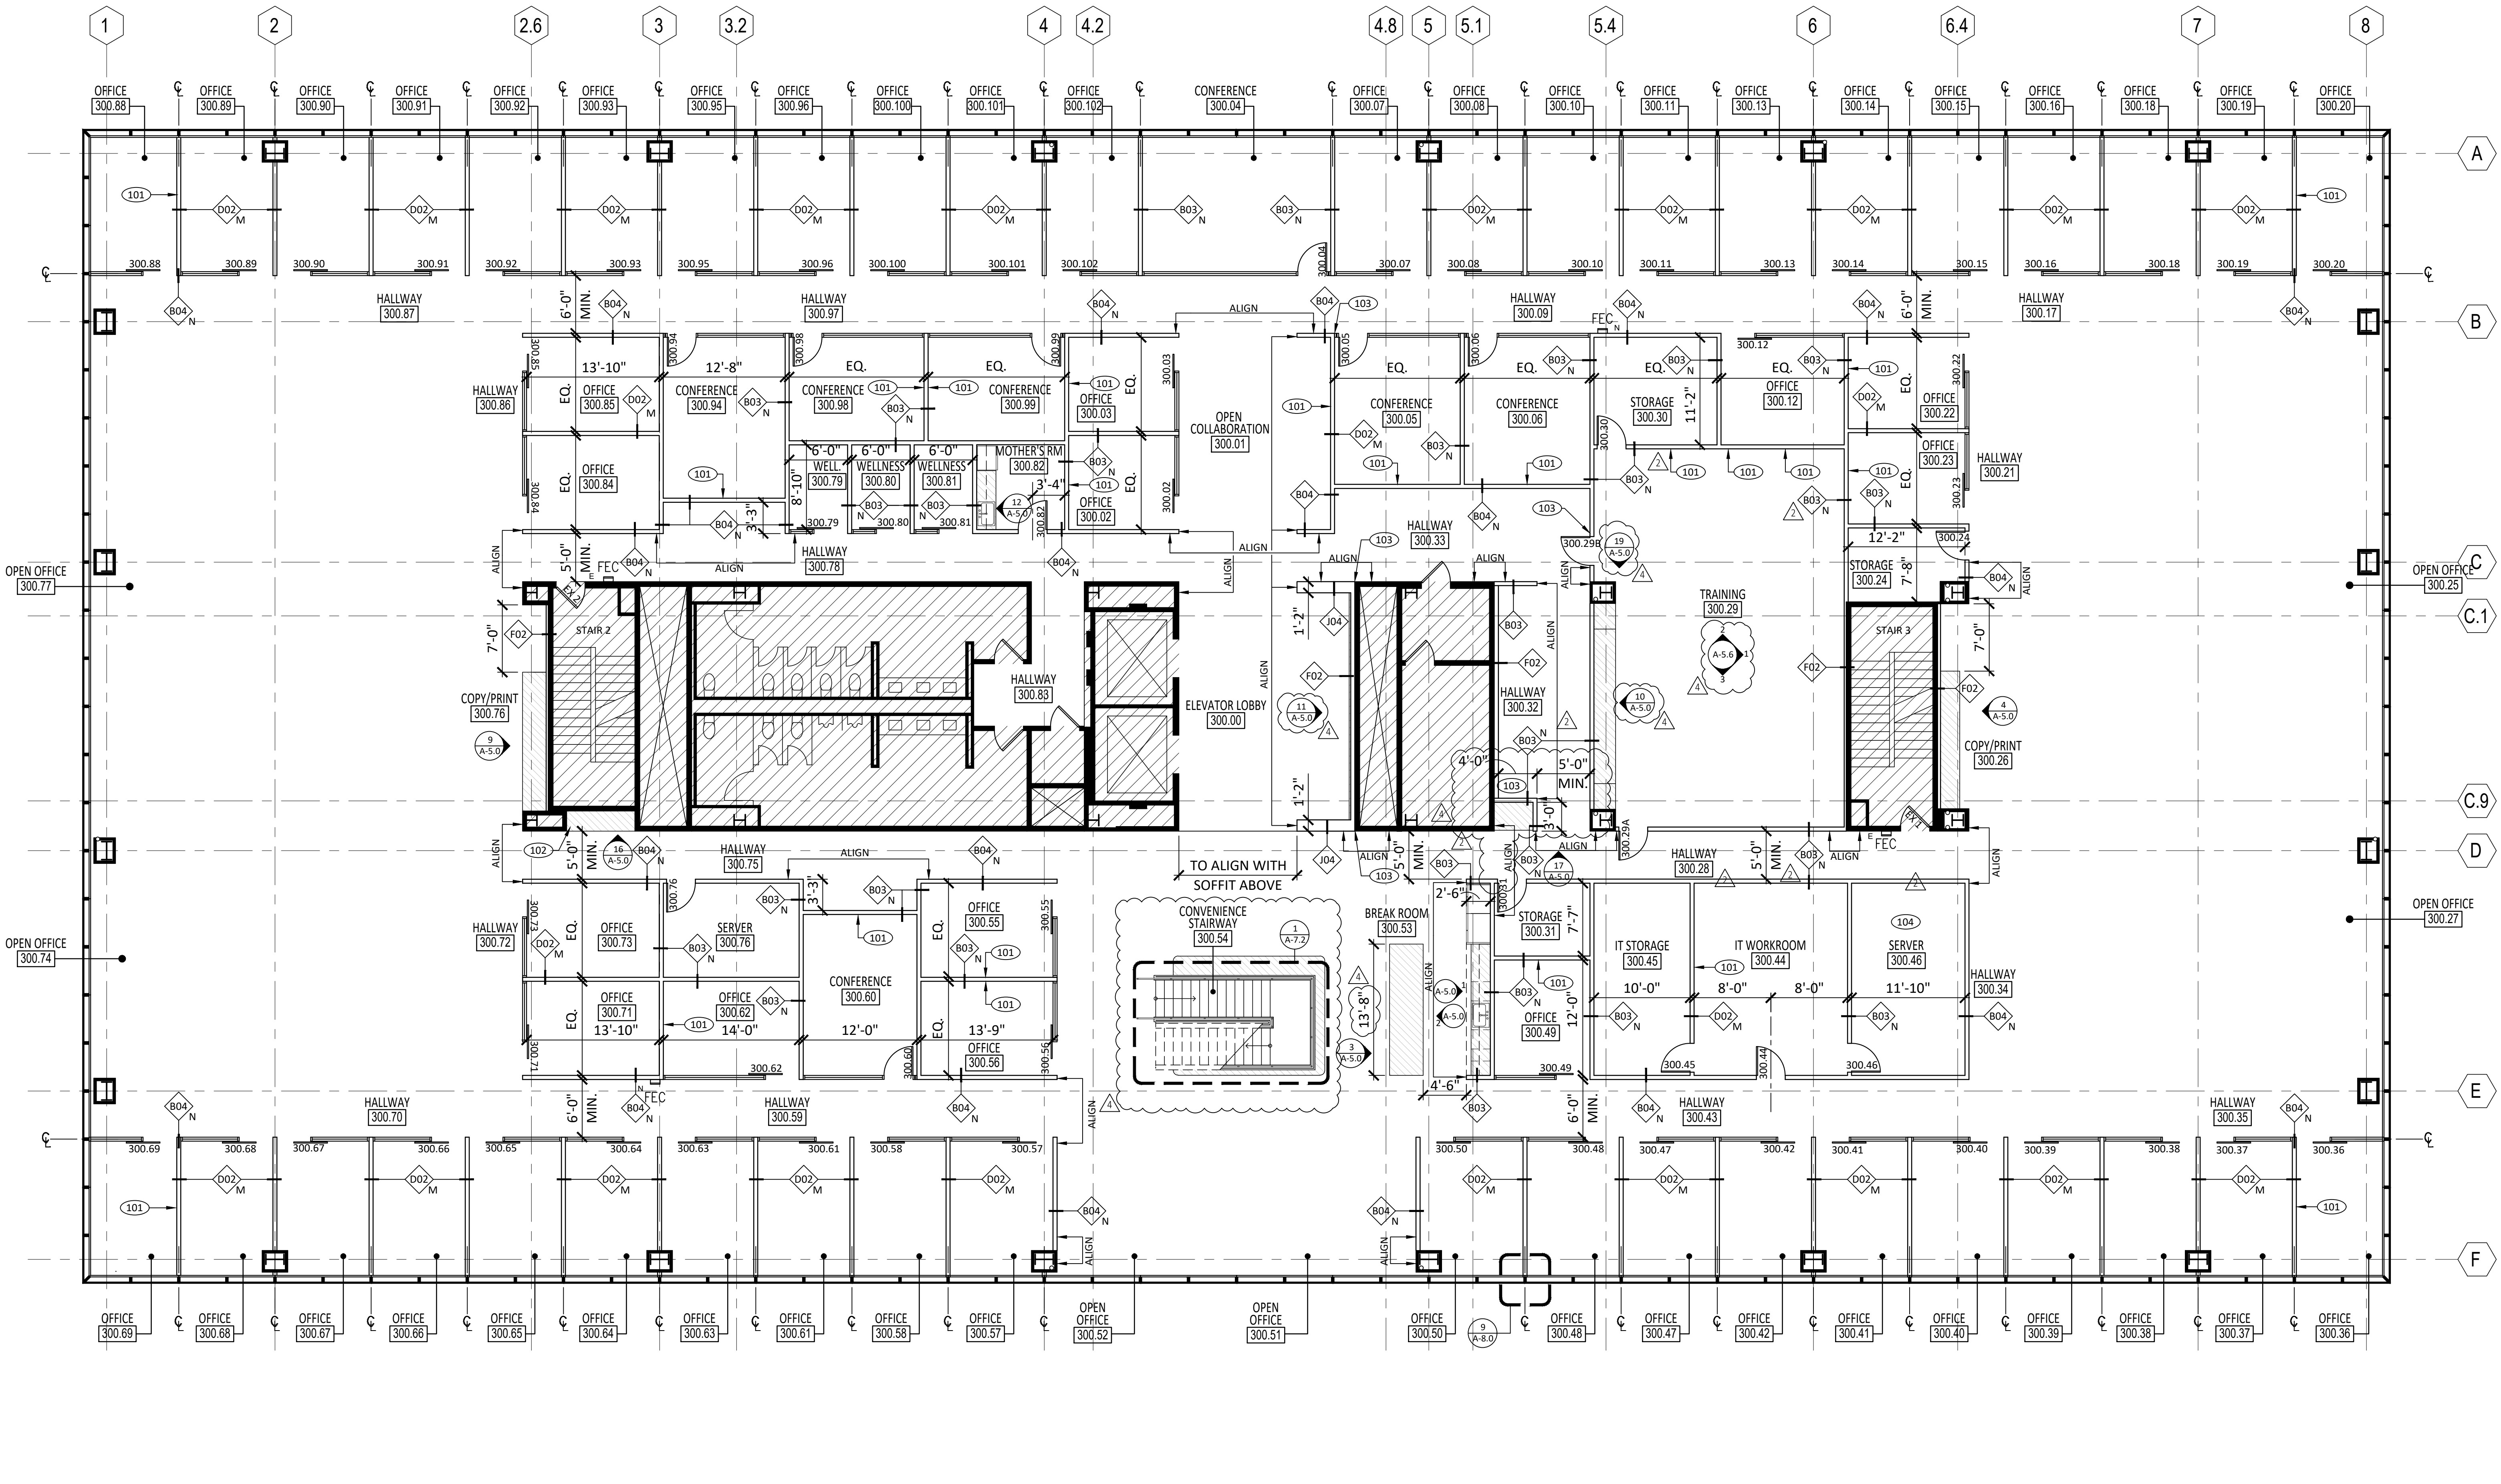

PARTITION SCHEDULE

MARK	FIRE RATING	UL #	DESCRIPTION	SSMA #	STUD SPACING (IN)	MAX DEFLECTION	MAX HT.	THCK.	DETAIL
A03	-	-	NOT USED	-	-	-	-	-	
B03	NR	NR	NON-RATED 3 5/8" METAL STUDS, FULL HEIGHT (SLAB-TO-SLAB) WITH ONE LAYER 5/8" GYPBOARD EACH SIDE.	3625125-33	16	L/240	16'-5"	4 7/8"	2/ A-8.0
B04	NR	NR	NON-RATED 3 5/8" METAL STUDS, FULL HEIGHT (SLAB-TO-SLAB) WITH ONE LAYER 5/8" GYPBOARD FULL HEIGHT ON OPEN CEILING SIDE AND ONE LAYER 5/8" GYPBOARD 6" ABOVE CEILING WHERE T-BAR CEILING OCCURS.	3625125-33	16	L/240	16'-5"	4 7/8"	3/ A-8.0
D02	NR	NR	2 1/2" METAL STUDS, CEILING HEIGHT (PARTITION TERMINATES AT UNDERSIDE OF CEILING) WITH ONE LAYER 5/8" GYPBOARD EACH SIDE.	2505125-33	24	L/240	11'-7"	3 3/4"	4/ A-8.0
F02	NR	NR	2 1/2" METAL STUD WITH ONE LAYER 5/8" GYPBOARD ON EXTERIOR. 1/2" AIR SPACE BETWEEN STUD AND WALL.	2505125-33	24	L/240	11'-7"	3 5/8"	5/ A-8.0
J03	NR	NR	TWO ROWS 3 5/8" METAL STUDS, FULL HEIGHT (SLAB-TO-SLAB) WITH ONE LAYER 5/8" GYPBOARD EACH SIDE. (1' MIN. AIR SPACE BETWEEN STUD ROWS)	3625125-33	16	L/240	22'-9"	10"	6/ A-8.0
J04	NR	NR	TWO ROWS 3 5/8" METAL STUDS, CEILING HEIGHT (PARTITION TERMINATES AT UNDERSIDE OF CEILING) WITH ONE LAYER 5/8" GYPBOARD EACH SIDE. (1' MIN. AIR SPACE BETWEEN STUD ROWS)	3625125-33	16	L/240	22'-9"	14"	7/ A-8.0

INSULATION TYPES

TYPE:	MINERAL WOOL INSULATION	FIBERGLASS BATT ACOUSTICAL INSULATION
A	1 1/2"	K 1 1/2"
B	2"	L 2"
C	2 1/2"	M 2 1/2"
D	3 1/2"	N 3 1/2"
E	6"	P 6 1/4"
F	MINERAL WOOL THERMAL INSULATION	FIBERGLASS BATT THERMAL INSULATION
G	2 1/2" (R-8)	R 2 1/2" (R-8)
H	3 1/2" (R-9)	S 3 1/2" (R-11)
J	6 1/4" (R-18)	T 6 1/4" (R-19)

MILLWORK NOTES

- FIELD VERIFY AREAS WHERE CABINETS ARE TO BE INSTALLED BEFORE FABRICATING CABINETS.
- CABINETS SHALL BE PLUMB, LEVEL AND SECURELY ATTACHED TO WALL USING ESTABLISHED METHODS WHICH WILL MEET ALL LEGAL REQUIREMENTS.
- CABINETS TO BE CONSTRUCTED OF 3/4" HIGH DENSITY PARTICLE BOARD WITH PLASTIC LAMINATE VENEER, FLUSH OVERLAY TYPE CONSTRUCTION, U.N.O. ALL WORK TO MEET M.I.C. STANDARDS. REFER TO DETAIL FOR LAMINATE SPEC. CONTRACTOR TO PROVIDE AND INSTALL ALL STIFFENERS, BRACING, BACK UP PLATES AND SUPPORTING BRACKETS AS REQUIRED.
- CABINET INTERIORS TO BE WHITE MELAMINE U.O.N.
- PROVIDE FULL-EXTENSION BALL BEARING GLIDES ON DRAWERS. ACCURIDE DRAWER SLIDES HC3800 OR EQUAL.
- PROVIDE CONCEALED HINGES ON CABINET DOORS.
- WORK SURFACES W/ NO CABINETS BELOW ARE TO BE SECURED TO WALL USING ANGLE IRONS. ANGLE IRONS TO BE ATTACHED TO STUDS AND AT PROPER HEIGHT FOR WORK SURFACE BEFORE GYPSUM BOARD IS APPLIED TO STUDS. CONCEALING VERTICAL ARM OF IRON. PROVIDE CLEAN, SMOOTH SURFACE AT OPENING OF WALL WHERE HORIZONTAL ARM PROTRUDES.
- CABINET PARTITION WALL LOADS. CABINET GRAVITY LOADS ARE IN COMPLIANCE OF 2019 CBC 1607.5. IN OFFICE BUILDINGS AND IN OTHER BUILDINGS WHERE PARTITION LOCATIONS ARE SUBJECT TO CHANGE, PROVISIONS FOR PARTITION WEIGHT SHALL BE MADE, WHETHER OR NOT PARTITIONS ARE SHOWN ON THE CONSTRUCTION DOCUMENTS, UNLESS THE SPECIFIED LIVE LOADS EXCEED 80 PSF (3.83 kN/m²). THE PARTITION LOAD SHALL NOT BE LESS THAN A UNIFORMLY DISTRIBUTED LIVE LOAD OF 15 PSF (0.72 kN/m²)
- PULLS: 6" PULL - FANTASY CREATIONS FCM-P-81-6. BRONZE FINISH UNLESS OTHERWISE NOTED.


PARTITION KEY NOTES

NO	DESCRIPTION
101	G.C. TO PROVIDE STRUCTURAL BACKING IN WALL FOR INSTALLATION OF DISPLAY MONITOR. COORDINATE WITH TENANT'S AV VENDOR FOR EXACT SIZE AND LOCATIONS.
102	CONTRACTOR TO VERIFY WIDTH, HEIGHT, AND DEPTH OF OPENING IN THE FIELD AND MODIFY NEW MILLWORK AS REQUIRED.
103	PROVIDE 1/4" REVEAL FOR FUTURE PAINT FINISH, REFER TO FINISH PLAN FOR FURTHER INFORMATION.
104	G.C. TO PROVIDE (1) 4' X 8' FIRE-RATED PLYWOOD BACKBOARD. CONFIRM LOCATION WITH CLIENT'S IT VENDOR.

PARTITION SHEET NOTES

- SEE AN-SHEET SERIES FOR ADDITIONAL NOTES AND ABBREVIATIONS.
- PARTITIONS DIMENSIONED TO FINISH FACE U.O.N. DO NOT ADJUST DIMENSIONS INDICATED AS "CLEAR" WITHOUT WRITTEN DIRECTION FROM ARCHITECT. DRAWINGS SHALL NOT BE SCALED. VERIFY ALL DIMENSIONS AND EXISTING AS BUILT FIELD CONDITIONS, INCLUDING FIELD MEASUREMENTS PRIOR TO START OF WORK. NOTIFY ARCHITECT WHERE DISCREPANCIES OCCUR.
- USE TYPE "X" GWB ON FIRE RATED PARTITIONS.
- USE CEMENTITIOUS BACKER BOARD (DUROCK) OR EQUAL AT PARTITIONS SCHEDULED TO RECEIVE CERAMIC TILE (U.O.N.). SEE FINISH PLAN FOR LOCATION OF TILE.
- SEE A-8 DETAIL SHEET SERIES FOR TYPICAL PARTITION DETAILS, EXTEND OF FRAMING AND FINISHES.
- WHERE FURRED PARTITIONS EXCEED MAXIMUM HEIGHT, BRACE TO ADJACENT STRUCTURE. SEE A-8 DETAIL SHEET SERIES.
- FIRE SAFE PENETRATIONS AT FIRE RESISTANT RATED PARTITIONS PER APPLICABLE UL ASSEMBLY. SEE A-8 SHEET SERIES FOR DETAILS.
- MAINTAIN INTEGRITY OF EXISTING FIRE RESISTANT RATED ASSEMBLIES FOR ALL PENETRATIONS.
- PROVIDE BLOCKING AS REQUIRED AT LOCATIONS INCLUDING, BUT NOT LIMITED TO: GRAB BARS, SHELVE, OVERHEAD CABINETS, SIGNAGE, TOILET ROOM ACCESSORIES, WALL MOUNT. EQUIPMENT, TV'S, BACK PAINTED GLASS LOCATIONS ETC.
- PROVIDE LEVEL 4 FINISH U.O.N. PROVIDE LEVEL 5 FINISH AT ALL PARTITIONS TO RECEIVE WALL COVERING. REFER TO FINISH PLANS FOR LOCATIONS AND ADDITIONAL INFORMATION.
- LARGE SCALE DRAWINGS TAKE PRECEDENCE OVER SMALL SCALE DRAWINGS. DETAILS TAKE PRECEDENCE OVERALL. NOTIFY ARCHITECT IN WRITING WHERE DISCREPANCIES OCCUR.
- ALL EXPOSED OUTSIDE GYPSUM BOARD CORNERS SHALL HAVE A CONTINUOUS METAL CORNER BEAD.
- DIMENSIONS TAKEN FROM PERIMETER EXTERIOR WINDOW WALL ARE TAKEN FROM THE INSIDE FACE OF THE VERTICAL MULLION. DIMENSIONS MARKED VERIFY IN FIELD, SHALL BE VERIFIED PRIOR TO START OF WORK UNLESS OTHERWISE NOTED.
- CONTRACTOR SHALL COORDINATE WORK WITH HVAC, MECHANICAL, ELECTRICAL, PLUMBING, DESIGN BUILD FIRE PROTECTION AND STRUCTURAL DRAWINGS AND REPORT TO THE ARCHITECT DISCREPANCIES FOR CORRECTION AND ADJUSTMENT PRIOR TO START OF NO ALLOWANCE WILL BE MADE FOR INCREASED COST DUE TO THE CONTRACTOR'S LACK OF COORDINATION.
- PATCH FLOOR AND WALL AREAS DAMAGED DUE TO NEW CONSTRUCTION OR WHERE PENETRATIONS HAVE BEEN MADE FOR MECHANICAL, ELECTRICAL AND PLUMBING WORK. FIRESAFE AT UL RATED ASSEMBLIES CONSISTENT WITH EXISTING UL RATING.
- WHERE EXISTING RATED ASSEMBLIES ARE SHOWN, CONTRACTOR IS REQUESTED TO FIELD VERIFY AS BUILT FIELD CONDITIONS TO CONFIRM RATINGS SHOWN. IF NON-COMPLIANT CONDITIONS ARE FOUND, DEMO AND REPLACE WITH NEW EQUIVALENT UL ASSEMBLY, OR REPORT FINDINGS TO OWNER/ARCHITECT IN WRITING WHO WILL PROVIDE WRITTEN DIRECTION.
- PATCH AND REPAIR ALL EXISTING PARTITIONS AFTER DEMOLITION WHERE DAMAGE HAS OCCURRED AT UNPROTECTED LOCATIONS. PLEASE NOTE THAT DEMOLITION ACTIVITY MAY OCCUR BEYOND WORK LIMITS SHOWN ON DEMOLITION PLAN DUE TO CONCEALED CONDITIONS.
- ALL LIGHT GAUGE COLD FORMED METAL FRAMING SHALL MEET OR EXCEED PROPERTIES SPECIFIED FOR THE CORRESPONDING MEMBER SIZE IN STEEL MANUFACTURERS ASSOCIATION (SSMA) PRODUCT TECHNICAL INFORMATION (ICC-ES REPORT NO. ER-4943P) AND SHALL COMPLY WITH APPLICABLE AMERICAN SOCIETY FOR TESTING AND MATERIALS, AMERICAN IRON AND STEEL, INSTITUTE S100 AND SPECIFIED TRUE GAUGE FLAT STEEL MIL THICKNESS THAT ONLY TRUE GAUGE FLAT STEEL CAN SATISFY. USE OF "EFFECTIVE THICKNESS" COLD REDUCED AFTERMARKET EQUIVALENT PRODUCT (EQ) STUDS FURNISHED BY EQ STUD MANUFACTURERS, VENDORS OR SUPPLIERS ARE NOT PERMITTED WITHOUT EXCEPTION.
- DENS-SHIELD WALLBOARD BY GEORGIA PACIFIC SHALL BE USED AT CONCEALED WET WALLS. CONCEALED WET WALLS SHALL CONSIST OF WALLS WITH CABINETS CONTAINING PLUMBING FOR ITEMS SUCH AS SINKS, WATER FILTRATION SYSTEMS, DISHWASHERS, ETC.
- PROVIDE ADA ROOM NAME SIGNAGE TO MATCH BUILDING STANDARDS AT ALL ROOM TYPES THROUGHOUT, U.O.N.

PARTITION LEGEND

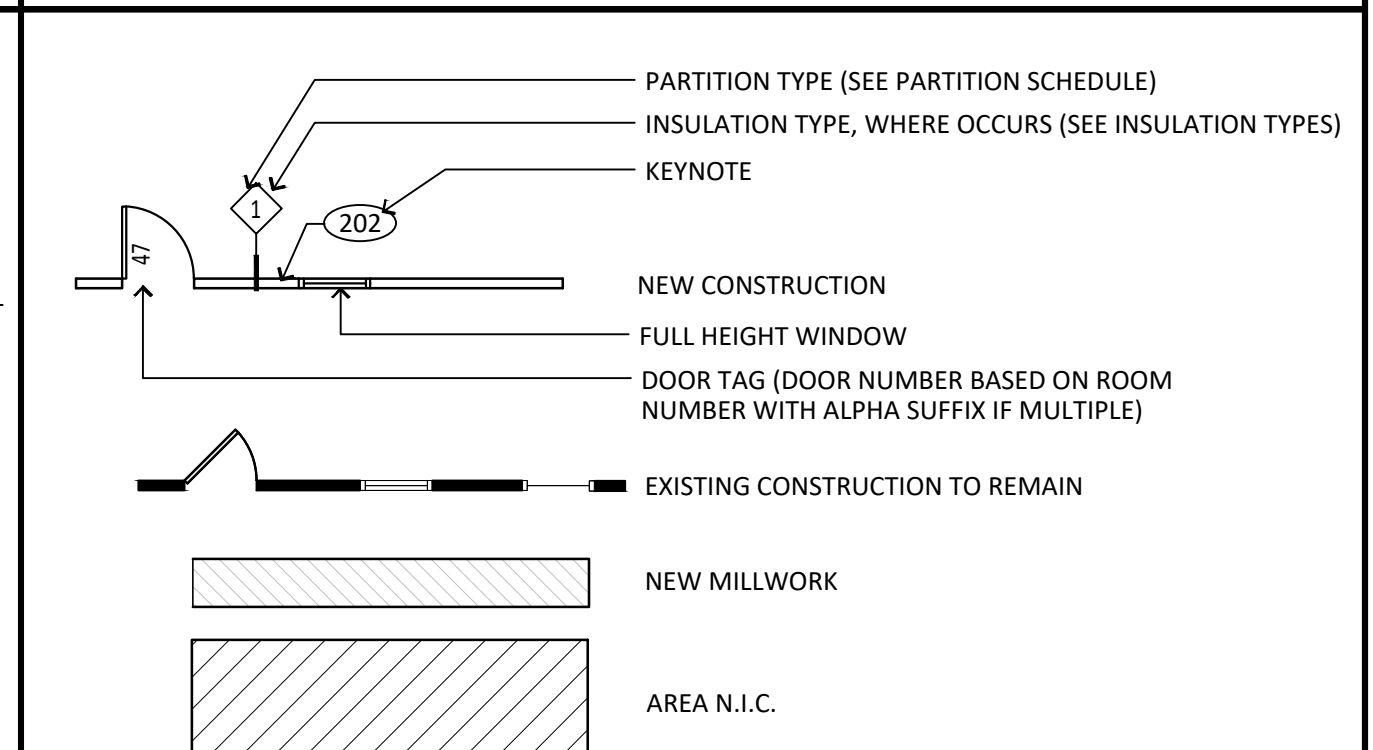

ANNOTATIONS

- D - DENOTES DEMOLITION
E - DENOTES EXISTING TO REMAIN
N - DENOTES NEW

1:9
ARCHITECTURE

1511 E. ORANGETHORPE AVE,
SUITE C FULLERTON, CA 92831

© 1:9 ARCHITECTURE, A CALIFORNIA CORPORATION. ALL
DRAWINGS AND WRITTEN MATERIAL HEREIN CONSTITUTE THE
ORIGINAL AND UNPUBLISHED WORK OF THE ARCHITECT, AND
THE SAME MAY NOT BE DUPLICATED, USED, OR DISCLOSED
WITHOUT THE WRITTEN CONSENT OF THE ARCHITECT.

ARCHITECT



CLIENT/PROJECT LOCATION

TARSUS

17700 LAGUNA CANYON RD
SUITE 300 AND SUITE 400
IRVINE, CA 92618




DATE	DESCRIPTION	DATE
05/09/2025	ISSUED FOR PLAN CHECK	05/09/2025
06/20/2025	REISSUED FOR PLAN CHECK	06/20/2025
07/17/2025	REISSUED FOR PLAN CHECK	07/17/2025
08/04/2025	REISSUED FOR PLAN CHECK	08/04/2025
09/29/2025	REVISION TO PERMIT	09/29/2025

DRAWN: DG CHECK: CP SCALE: 1/8"=1'-0"

JOB NO:

TITLE: FOURTH FLOOR -
PARTITION PLAN

SHEET:
4A-1.0

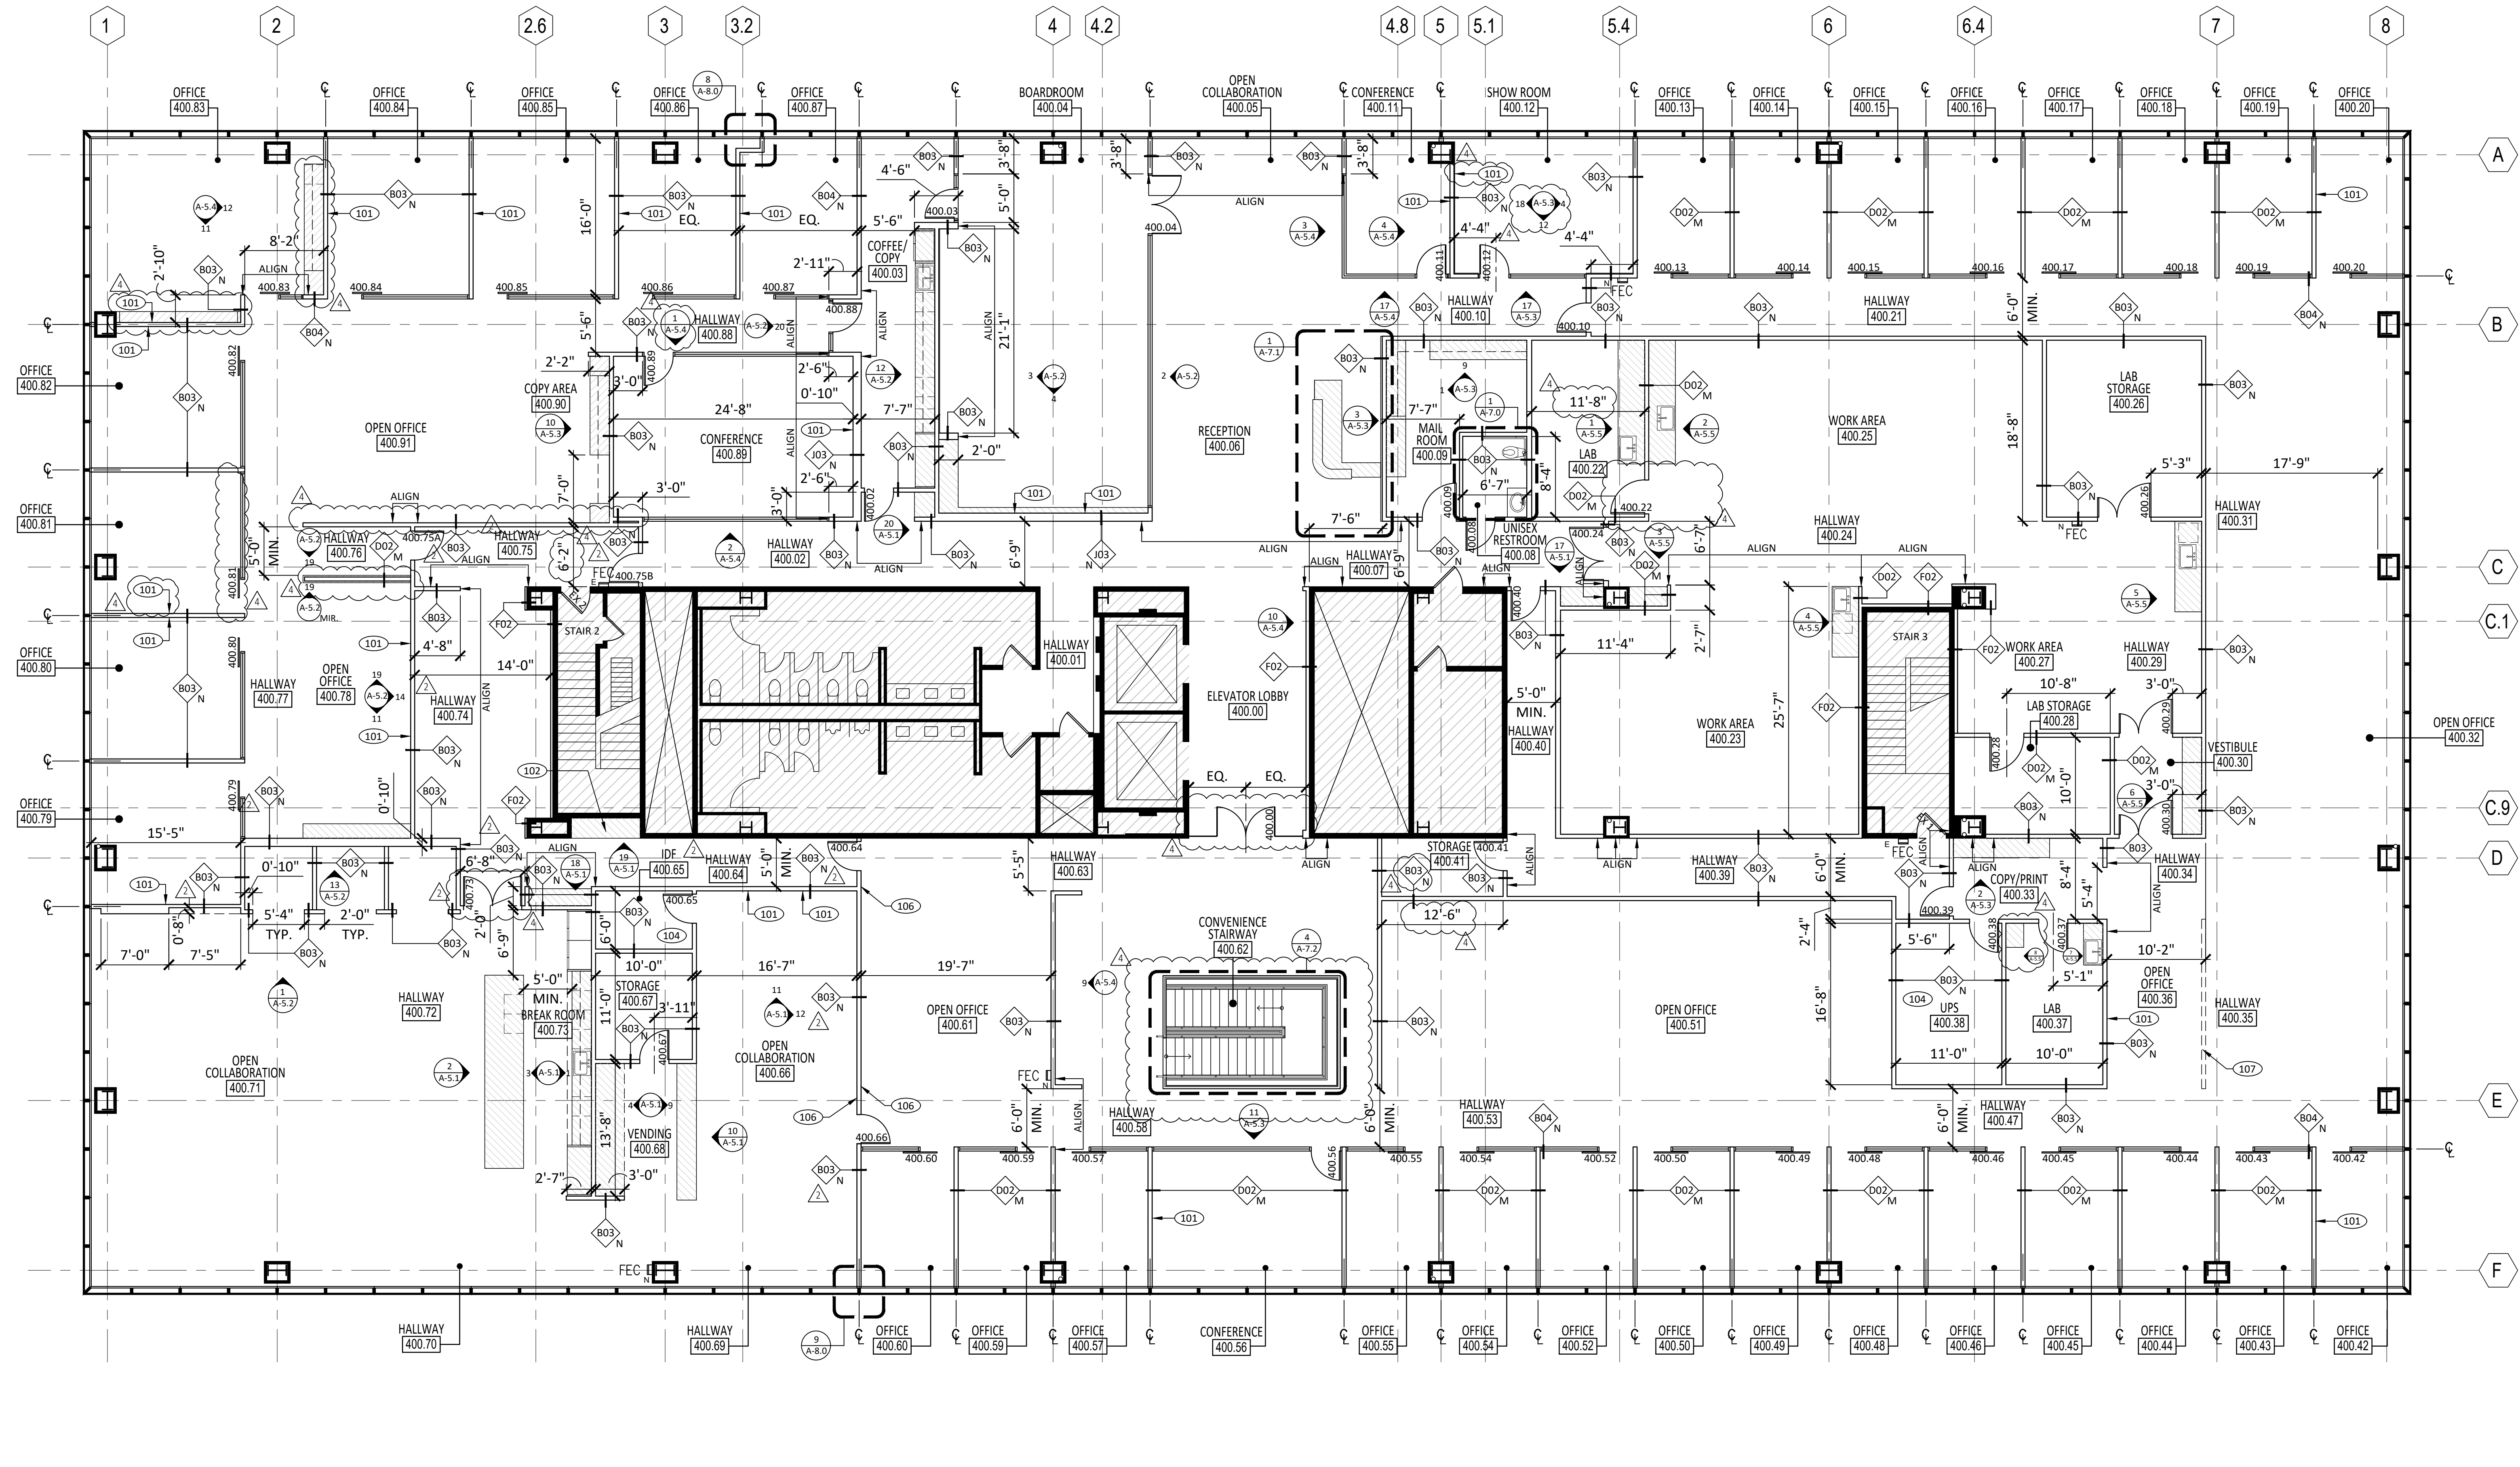

PARTITION SCHEDULE

MARK	FIRE RATING	UL #	DESCRIPTION	SSMA #	STUD SPACING (IN)	MAX DEFLECTION	MAX HT.	THICK.	DETAIL
A03	-	-	NOT USED	-	-	-	-	-	-
B03	NR	NR	NON-RATED 3 5/8" METAL STUDS, FULL HEIGHT (SLAB-TO-SLAB) WITH ONE LAYER 5/8" GYPBOARD EACH SIDE.	3625125-33	16	L/240	16'-5"	4 7/8"	2/ A-8.0
B04	NR	NR	NON-RATED 3 5/8" METAL STUDS, FULL HEIGHT (SLAB-TO-SLAB) WITH ONE LAYER 5/8" GYPBOARD EACH SIDE. HEIGHT ON OPEN CEILING SIDE AND ONE LAYER 5/8" GYPBOARD 6" ABOVE CEILING WHERE T-BAR CEILING OCCURS.	3625125-33	16	L/240	16'-5"	4 7/8"	3/ A-8.0
D02	NR	NR	2 1/2" METAL STUDS, CEILING HEIGHT (PARTITION TERMINATES AT UNDERSIDE OF CEILING) WITH ONE LAYER 5/8" GYPBOARD EACH SIDE.	2505125-33	24	L/240	11'-7"	3 3/4"	4/ A-8.0
F02	NR	NR	2 1/2" METAL STUD WITH ONE LAYER 5/8" GYPBOARD ON EXTERIOR. 1/2" AIR SPACE BETWEEN STUD AND WALL.	2505125-33	24	L/240	11'-7"	3 5/8"	5/ A-8.0
J03	NR	NR	TWO ROWS 3 5/8" METAL STUDS, FULL HEIGHT (SLAB-TO-SLAB) WITH ONE LAYER 5/8" GYPBOARD EACH SIDE. (1' MIN. AIR SPACE BETWEEN STUD ROWS)	3625125-33	16	L/240	22'-9"	10"	6/ A-8.0
J04	NR	NR	TWO ROWS 3 5/8" METAL STUDS, CEILING HEIGHT (PARTITION TERMINATES AT UNDERSIDE OF CEILING) WITH ONE LAYER 5/8" GYPBOARD EACH SIDE. (1' MIN. AIR SPACE BETWEEN STUD ROWS)	3625125-33	16	L/240	22'-9"	14"	7/ A-8.0

INSULATION TYPES

TYPE:	MINERAL WOOL INSULATION	FIBERGLASS BATT ACOUSTICAL INSULATION
A	1 1/2"	K 1 1/2"
B	2"	L 2"
C	2 1/2"	M 2 1/2"
D	3 1/2"	N 3 1/2"
E	EXISTING INSULATION TO REMAIN (ANY TYPE)	P 6 1/4"
F	6"	

TYPE:	MINERAL WOOL THERMAL INSULATION	FIBERGLASS BATT THERMAL INSULATION
G	2 1/2" (R-8)	R 2 1/2" (R-8)
H	3 1/2" (R-9)	S 3 1/2" (R-11)
J	6 1/4" (R-18)	T 6 1/4" (R-13)

MILLWORK NOTES

- FIELD VERIFY AREAS WHERE CABINETS ARE TO BE INSTALLED BEFORE FABRICATING CABINETS.
- CABINETS SHALL BE PLUMB, LEVEL AND SECURELY ATTACHED TO WALL USING ESTABLISHED METHODS WHICH WILL MEET ALL LEGAL REQUIREMENTS.
- CABINETS TO BE CONSTRUCTED OF 3/4" HIGH DENSITY PARTICLE BOARD WITH PLASTIC LAMINATE VENEER, FLUSH OVERLAY TYPE CONSTRUCTION, U.N.O. ALL WORK TO MEET W.I.C. STANDARDS. REFER TO DETAIL FOR LAMINATE SPEC. CONTRACTOR TO PROVIDE AND INSTALL ALL STIFFENERS, BRACINGS, BACK UP PLATES AND SUPPORTING BRACKETS AS REQUIRED.
- CABINET INTERIORS TO BE WHITE MELAMINE U.O.N.
- PROVIDE FULL-EXTENSION BALL BEARING GLIDES ON DRAWERS. ACCURIDE DRAWER SLIDES HC3800 OR EQUAL.
- PROVIDE CONCEALED HINGES ON CABINET DOORS.
- WORK SURFACES W/ NO CABINETS BELOW ARE TO BE SECURED TO WALL USING ANGLE IRONS. ANGLE IRONS TO BE ATTACHED TO STUDS AND AT PROPER HEIGHT FOR WORK SURFACE BEFORE GYPSUM BOARD IS APPLIED TO STUDS, CONCEALING VERTICAL ARM OF IRON. PROVIDE CLEAN, SMOOTH SURFACE AT OPENING OF WALL WHERE HORIZONTAL ARM PROTRUDES.
- CABINET PARTITION WALL LOADS. CABINET GRAVITY LOADS ARE IN COMPLIANCE OF 2019 CBC 1607.5. IN OFFICE BUILDINGS AND IN OTHER BUILDINGS WHERE PARTITION LOCATIONS ARE SUBJECT TO CHANGE, PROVISIONS FOR PARTITION WEIGHT SHALL BE MADE, WHETHER OR NOT PARTITIONS ARE SHOWN ON THE CONSTRUCTION DOCUMENTS, UNLESS THE SPECIFIED LIVE LOADS EXCEED 80 PSF (3.83 kN/m²). THE PARTITION LOAD SHALL NOT BE LESS THAN A UNIFORMLY DISTRIBUTED LIVE LOAD OF 15 PSF (0.72 kN/m²).
- PULLS: 6" PULL - FANTASY CREATIONS FCM-P-81-6. BRONZE FINISH U.O.N.


PARTITION KEY NOTES

NO	DESCRIPTION
101	G.C. TO PROVIDE STRUCTURAL BACKING IN WALL FOR INSTALLATION OF DISPLAY MONITOR. COORDINATE WITH TENANT'S AV VENDOR FOR EXACT SIZE AND LOCATIONS.
102	CONTRACTOR TO VERIFY WIDTH, HEIGHT, AND DEPTH OF OPENING IN THE FIELD AND MODIFY NEW MILLWORK AS REQUIRED.
103	G.C. TO PROVIDE 6'-0" LENGTH STAINLESS STEEL CORNER GUARD.
104	G.C. TO PROVIDE (1' 4" X 8" FIRE-RATED PLYWOOD BACKBOARD. CONFIRM LOCATION WITH CLIENT'S IT VENDOR.
105	NOT USED
106	PROVIDE 1/4" REVEAL FOR FUTURE PAINT FINISH, REFER TO FINISH PLAN FOR FURTHER INFORMATION.
107	FUTURE ACOUSTIC CURTAIN PROVIDED BY OTHERS.

PARTITION SHEET NOTES

- SEE AN-SHEET SERIES FOR ADDITIONAL NOTES AND ABBREVIATIONS.
- PARTITIONS DIMENSIONED TO FINISH FACE U.O.N. DO NOT ADJUST DIMENSIONS INDICATED AS "CLEAR" WITHOUT WRITTEN DIRECTION FROM ARCHITECT. DRAWINGS SHALL NOT BE SCALED. VERIFY ALL DIMENSIONS AND EXISTING AS BUILT FIELD CONDITIONS, INCLUDING FIELD MEASUREMENTS PRIOR TO START OF WORK. NOTIFY ARCHITECT WHERE DISCREPANCIES OCCUR.
- USE TYPE "X" GWB ON FIRE RATED PARTITIONS.
- USE CEMENTITIOUS BACKER BOARD (DURLOCK) OR EQUAL AT PARTITIONS SCHEDULED TO RECEIVE CERAMIC TILE (U.O.N.). SEE FINISH PLAN FOR LOCATION OF TILE.
- SEE A-8 DETAIL SHEET SERIES FOR TYPICAL PARTITION DETAILS, EXTEND OF FRAMING AND FINISHES.
- WHERE FURRED PARTITIONS EXCEED MAXIMUM HEIGHT, BRACE TO ADJACENT STRUCTURE. SEE A-8 DETAIL SHEET SERIES.
- FIRE SAFE PENETRATIONS AT FIRE RESISTANT RATED PARTITIONS PER APPLICABLE UL ASSEMBLY. SEE A-8 SHEET SERIES FOR DETAILS.
- MAINTAIN INTEGRITY OF EXISTING FIRE RESISTANT RATED ASSEMBLIES FOR ALL PENETRATIONS.
- PROVIDE BLOCKING AS REQUIRED AT LOCATIONS INCLUDING, BUT NOT LIMITED TO: GRAB BARS, SHELVEING, OVERHEAD CABINETS, SIGNAGE, TOILET ROOM ACCESSORIES, WALL MOUNT. EQUIPMENT, TV'S, BACK PAINTED GLASS LOCATIONS ETC.
- PROVIDE LEVEL 4 FINISH U.O.N. PROVIDE LEVEL 5 FINISH AT ALL PARTITIONS TO RECEIVE WALL COVERING. REFER TO FINISH PLANS FOR LOCATIONS AND ADDITIONAL INFORMATION.
- LARGE SCALE DRAWINGS TAKE PRECEDENCE OVER SMALL SCALE DRAWINGS. DETAILS TAKE PRECEDENCE OVERALL. NOTIFY ARCHITECT IN WRITING WHERE DISCREPANCIES OCCUR.
- ALL EXPOSED OUTSIDE GYPSUM BOARD CORNERS SHALL HAVE A CONTINUOUS METAL CORNER BEAD. DIMENSIONS TAKEN FROM PERIMETER EXTERIOR WINDOW WALL ARE TAKEN FROM THE INSIDE FACE OF THE VERTICAL MULLION. DIMENSIONS MARKED VERIFY IN FIELD, SHALL BE VERIFIED PRIOR TO START OF WORK UNLESS OTHERWISE NOTED.
- CONTRACTOR SHALL COORDINATE WORK WITH HVAC, MECHANICAL, ELECTRICAL, PLUMBING, DESIGN BUILD FIRE PROTECTION AND STRUCTURAL DRAWINGS AND REPORT TO THE ARCHITECT DISCREPANCIES FOR CORRECTION AND ADJUSTMENT PRIOR TO START OF NO ALLOWANCE WILL BE MADE FOR INCREASED COST DUE TO THE CONTRACTOR'S LACK OF COORDINATION.
- PATCH FLOOR AND WALL AREAS DAMAGED DUE TO NEW CONSTRUCTION OR WHERE PENETRATIONS HAVE BEEN MADE FOR MECHANICAL, ELECTRICAL AND PLUMBING WORK. FIRESAFE AT UL RATED ASSEMBLIES CONSISTENT WITH EXISTING UL RATING.
- WHERE EXISTING RATED ASSEMBLIES ARE SHOWN, CONTRACTOR IS REQUESTED TO FIELD VERIFY AS BUILT FIELD CONDITIONS TO CONFIRM RATINGS SHOWN. IF NON-COMPLIANT CONDITIONS ARE FOUND, DEMO AND REPLACE WITH NEW EQUIVALENT UL ASSEMBLY, OR REPORT FINDINGS TO OWNER/ARCHITECT IN WRITING WHO WILL PROVIDE WRITTEN DIRECTION.
- PATCH AND REPAIR ALL EXISTING PARTITIONS AFTER DEMOLITION WHERE DAMAGE HAS OCCURRED AT UNPROTECTED LOCATIONS. PLEASE NOTE THAT DEMOLITION ACTIVITY MAY OCCUR BEYOND WORK LIMITS SHOWN ON DEMOLITION PLAN DUE TO CONCEALED CONDITIONS.
- ALL LIGHT GAGE COLD FORMED METAL FRAMING SHALL MEET OR EXCEED PROPERTIES SPECIFIED FOR THE CORRESPONDING MEMBER SIZE IN STEEL MANUFACTURERS ASSOCIATION (SSMA) PRODUCT TECHNICAL INFORMATION (ICC-ES REPORT NO. E-4943P) AND SHALL COMPLY WITH APPLICABLE AMERICAN SOCIETY FOR TESTING AND MATERIALS, AMERICAN IRON AND STEEL INSTITUTE 5100 AND SPECIFIED TRUE GAGE FLAT STEEL MIL THICKNESS THAT ONLY TRUE GAUGE FLAT STEEL CAN SATISFY. USE OF "EFFECTIVE THICKNESS" COLD REDUCED AFTERMARKET EQUIVALENT PRODUCT (EQ) STUDS FURNISHED BY EQ STUD MANUFACTURERS, VENDORS OR SUPPLIERS ARE NOT PERMITTED WITHOUT EXCEPTION.
- DENS-SHIELD WALLBOARD BY GORGIA PACIFIC SHALL BE USED AT CONCEALED WET WALLS. CONCEALED WET WALLS SHALL CONSIST OF WALLS WITH CABINETS OR CONTAINING PLUMBING FOR ITEMS SUCH AS SINKS, WATER FILTRATION SYSTEMS, DISHWASHERS, ETC.

PARTITION LEGEND

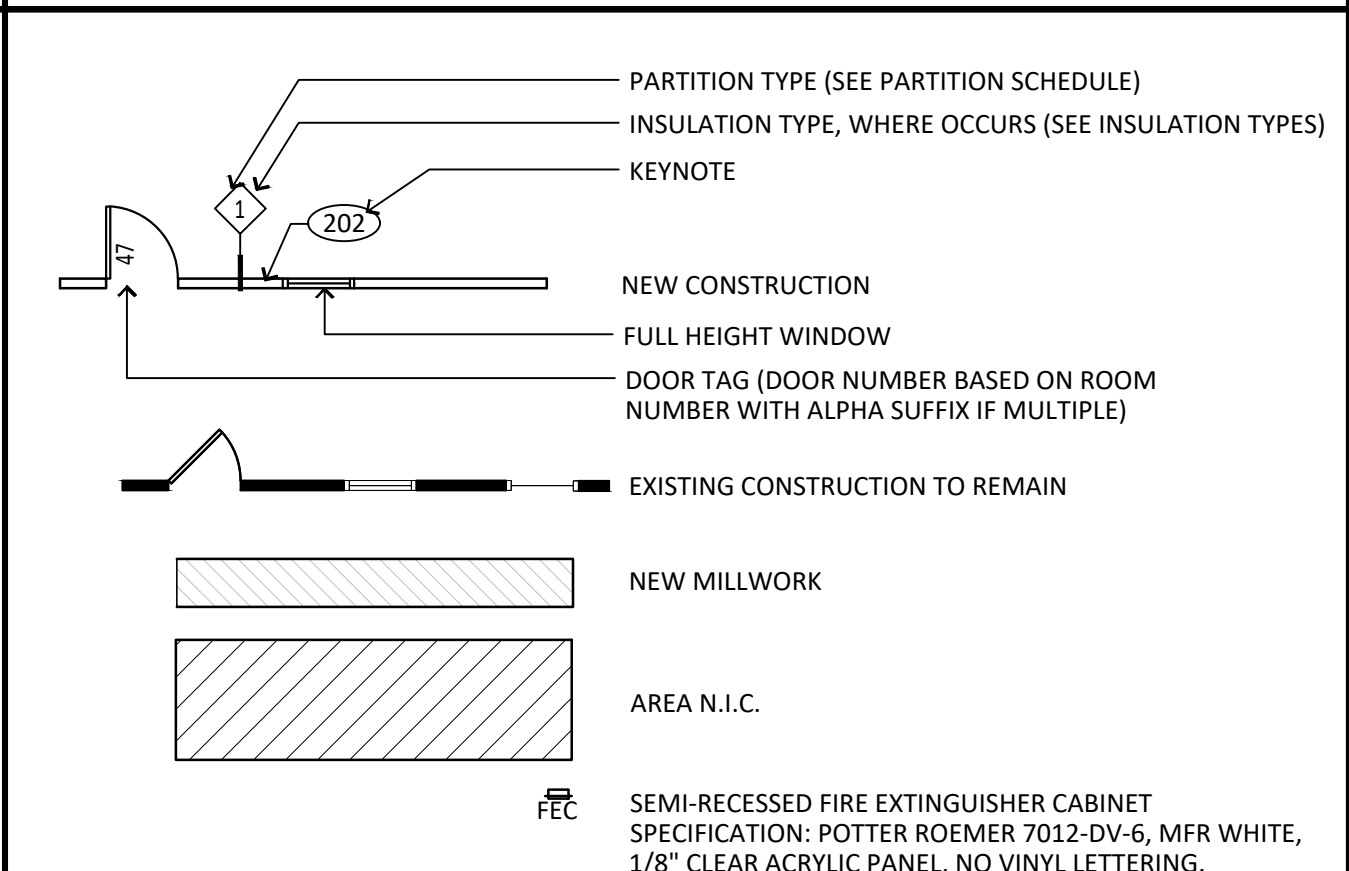

ANNOTATIONS

- D - DENOTES DEMOLITION
- E - DENOTES EXISTING TO REMAIN
- N - DENOTES NEW