



1437 4th Street, 4th Floor
Santa Monica, California 90401
t +1 310 453 2800 | www.hlw.design

**IDG STRUCTURAL
ENGINEERING, INC.**
STRUCTURAL ENGINEER
10866 Wimer Country Road
Los Angeles, CA 91040
t +1 323 257 8854

ARC ENGINEERING
MEP ENGINEER
3045 N Hollywood Way, Burbank,
CA 91505
t +1 (818) 508-6300

SPARK
LIGHTING CONSULTANT
5 Penn Plaza, Level 5, New York,
NY 10001
t +1 212-353-4673

PLANNET
TELECOMMUNICATION CONSULTANT
Ten Pointe Drive, Suite 410
Brea, CA 92821
t +1 714.982.5800

NO.	DATE	ISSUE OR REVISION
A	03/17/2025	ISSUED FOR PLAN CHECK 1- PHASE 1
B	04/28/2025	ISSUED FOR PLAN CHECK 2- PHASE 1
D	06/27/2025	ISSUED FOR CONSTRUCTION - PHASE 1


KEY PLAN



NORTH

A simple compass rose with a circle and a vertical line. The top half is labeled 'NORTH' and the bottom half is labeled 'SOUTH'. The left half is labeled 'WEST' and the right half is labeled 'EAST'.

SEAL/ SIGNATURE

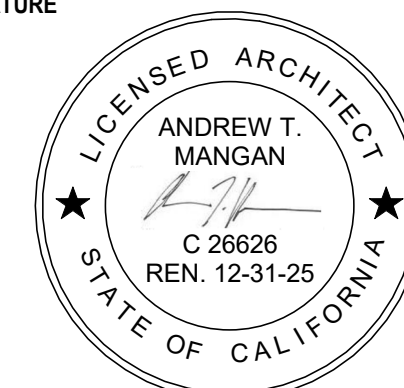

SHEET TITLE:

LEVEL 1 - FLOOR PLAN -
EAST

PROJECT NO.
24235

QA BY
Checker

A-100



1 LEVEL 1 - CONSTRUCTION - EAST




GENERAL CONSTRUCTION NOTES:

- | | |
|--|--|
| 1. THE TERM "FINISH FLOOR", WHERE INDICATED ON THE DRAWING, REFERS TO THE NORMAL FINISHED FLOOR LEVEL OF THAT FLOOR. HEIGHTS NOTED IN SCHEDULES ARE HEIGHTS ABOVE FINISH FLOOR, UNLESS OTHERWISE NOTED. | 16. ALL ITEMS RECESSED INTO RATED PARTITIONS (SUCH AS OUTLET BOXES, PANEL BOXES, ETC.) SHALL HAVE THOSE OPENINGS PROTECTED WITH BACK-UP MATERIALS SO AS TO RETAIN THE INTEGRITY OF THE PARTITION RATING THROUGHOUT. PROTECTION OF THESE OPENINGS SHALL BE IN STRICT CONFORMITY WITH THE BUILDING CODE, LOCAL ORDINANCES AND BE TO THE SATISFACTION OF THE LOCAL AUTHORITIES HAVING JURISDICTION. |
| 2. ALL WALLS AND PARTITIONS ARE DIMENSIONED TO THEIR NOMINAL SIZES, UNLESS OTHERWISE NOTED. WHERE DIMENSIONS ARE NOTED AS "MINIMUM", MINIMUM MEANS MINIMUM. CLEARANCES SHALL BE AS NOTED. | 17. ALL EXISTING CONDITIONS NOT WITHIN SCOPE OF WORK TO BE PROTECTED OR RELOCATED THROUGHOUT THE DURATION OF WORK AND REPLACED UPON COMPLETION OF WORK. REFER TO ENGINEERS DRAWINGS FOR ADDITIONAL INFORMATION. |
| 3. ALL DIMENSIONS ARE MEASURED FROM FINISH TO FINISH UNLESS OTHERWISE NOTED OTHERWISE. | 18. DEMOLITION IS DEFINED AS IN EXCESS OF THAT REQUIRED TO REMOVE THE EXISTING MATERIALS TO RESTORE AFFECTED AREAS TO ORIGINAL CONDITION AT NO COST TO THE OWNER. |
| 4. ALL DIMENSIONS TO BE VERIFIED IN FIELD. ANY DISCREPANCIES SHALL BE BROUGHT TO THE ARCHITECT'S ATTENTION PRIOR TO COMMENCEMENT OF WORK. | 19. ALL EXISTING SPRAYED FIRE RESISTANT MATERIALS TO BE MAINTAINED AND PROTECTED. PROVIDE SPRAYED FIREPROOFING TO MATCH EXISTING ADJACENT RATING AT AREAS AFFECTED BY, BUT NOT LIMITED TO, REMOVED PARTITIONS. PROVIDE SPRAYED FIREPROOFING TO ANY EXISTING EXPOSED STEEL, DECK, BEAM, AND COLUMNS AND ASSOCIATED COMPONENTS. REFER TO PROJECT MANUAL FOR ADDITIONAL INFORMATION. |
| 5. THE DISTANCE FROM DOOR DAMBS TO ADJACENT PARTITIONS SHALL NOT BE LESS THAN 4", UNLESS OTHERWISE NOTED OR APPROVED BY ARCHITECT. | 20. MATCH EXISTING ADJACENT RATING AT AREAS AFFECTED BY, BUT NOT LIMITED TO, REMOVED PARTITIONS. PROVIDE SPRAYED FIREPROOFING TO ANY EXISTING EXPOSED STEEL, DECK, BEAM, AND COLUMNS AND ASSOCIATED COMPONENTS. REFER TO PROJECT MANUAL FOR ADDITIONAL INFORMATION. |
| 6. FOR LOCATIONS OF ADDITIONAL CLEAN OUT DOORS AND ACCESS DOORS IN PARTITIONS AND HUNG CEILING NOT SHOWN ON PLANS, REFER TO THE MECHANICAL, PLUMBING, FIRE PROTECTION AND ELECTRICAL PLANS AND PROVIDE ACCESS DOORS AT LOCATIONS REQUIRING ACCESS TO MECHANICAL EQUIPMENT. THE ARCHITECT SHALL BE CONSULTED FOR FINAL LOCATIONS AND ACCESS DOOR SIZES. | 21. REFER TO DEMOLITION PLANS AND CONSTRUCTION PLANS FOR SPECIFIC EXTENT OF DEMOLITION AND ALL ADDITIONAL WORK. |
| 7. THE GENERAL CONTRACTOR SHALL FURNISH AND INSTALL ALL LINTELS, STRUTS, BRACKETS, HANGERS, ETC. WHEREVER NECESSARY TO SUPPORT EXISTING OR NEW CEILING, WALLS, FLOORS, ROOFS, OR OTHER STRUCTURES. PROVIDE ALL LINTELS IN FIELD ALL ALIGNMENTS SHOWN IN DRAWINGS. IF ALIGNMENT IS NOT ACHIEVABLE, FURNISH COLUMN OR WALL TO PROVIDE ALIGNMENT. | 22. EXISTING FLOOR SLAB TO BE FLASH-PATCHED/LEVELLED AS REQUIRED TO PROVIDE A LEVEL AND CONSISTENT SURFACE TO RECEIVE SCHEDULED FINISHES. WHERE STONE IS REMOVED, DO CO TO ENSURE ALL REMEDIAL WORK AS REQUIRED TO COVER EXISTING FINISHES. |
| 8. ALL EXTERIOR CORNERS AT GYPSUM WALLBOARD CONSTRUCTION SHALL HAVE METAL CORNER BEADS INSTALLED. | 23. PROVIDE FIRE RETARDANT IN-WALL BLOCKING FOR ALL WALL MOUNTED PLUMBING, GLASS MARKER BOARDS, AND MILLWORK. |
| 9. ALL INTERIOR CORNERS AT GYPSUM WALLBOARD CONSTRUCTION SHALL HAVE METAL CORNER BEADS INSTALLED. | 24. PROVIDE FIRE RETARDANT IN-WALL BLOCKING FOR ALL WALL MOUNTED TV'S, CONTRACTOR TO COORDINATE FINAL LOCATIONS AND MOUNTING HEIGHTS WITH AV DRAWINGS. |
| 10. AT ALL AREAS WHERE STRIPS ARE REQUIRED, THE VERTICAL AND HORIZONTAL SURFACES SHALL BE GYPSUM WALLBOARD, UNLESS OTHERWISE NOTED. | 25. ADJUSTOR TO FIRE STOP ALL PENETRATIONS THROUGH RATED ASSEMBLIES, TVP. |
| 11. ALL FINISHING STRIPS ARE REQUIRED AT INTERIOR DOOR OPENINGS WHERE DIFFERENT TYPES OF FLOOR FINISHES OCCUR IN ADJOINING ROOMS, UNLESS OTHERWISE NOTED. WHERE ADJOINING ROOMS AND SPACES HAVE THE SAME KIND OF FLOOR COVERING OF DIFFERENT COLOR, EXTEND THE FLOOR COVERING THROUGH THE DOOR OPENING AND FINISH AT TRANSITION POINT. | 26. PROVIDE PORTABLE FIRE EXTINGUISHER WITH A RATING OF NOT LESS THAN 2A OR 2A10BC WITH 75' TRAVEL DISTANCE, TO ALL PORTIONS OF THE BUILDING ON EACH FLOOR; ALSO DURING CONSTRUCTION, ALL NEW FIRE EXTINGUISHER CABINETS SHOULD BE RECESSED AND MATCH EXISTING CABINET TYPE AND FINISH. |
| 12. ALL VERTICAL PIPES AND DUCTS ARE TO BE FURRED OUT WITH MATERIALS TO MATCH ADJACENT SURFACES. | 27. ALL EXISTING PERIMETER WINDOW SHADE ENCLOSURES TO REMAIN AND BE PROTECTED THROUGHOUT CONSTRUCTION, UNLESS OTHERWISE NOTED. PROVIDE NEW SHADES AS PER FINISH PLANS AND SCHEDULE. |
| 13. ALL EQUIPMENT SECURED TO INTERIOR PARTITIONS SHALL BE FASTENED DIRECTLY TO METAL STUDS. PROVIDE METAL STRAPPING OR TYPED TO ALL MOUNTED EQUIPMENT, CABINETS AND FUTURE TV LOCATIONS AS SHOWN. | |
| 14. ALL OPENINGS AT GYPSUM WALLBOARD PARTITIONS FOR DUCTS, ELECTRIC PANEL BOXES, ETC. ARE TO BE STEEL, STUD-FRAMED OPENINGS. | |
| 15. ALL ITEMS RECESSED INTO RATED PARTITIONS (SUCH AS OUTLET BOXES, PANEL BOXES, ETC.) SHALL HAVE THOSE OPENINGS PROTECTED WITH BACK-UP MATERIALS SO AS TO RETAIN THE INTEGRITY OF THE PARTITION RATING THROUGHOUT. PROTECTION OF THESE OPENINGS SHALL BE IN STRICT CONFORMITY WITH THE BUILDING CODE, LOCAL ORDINANCES AND BE TO THE SATISFACTION OF THE LOCAL AUTHORITIES HAVING JURISDICTION. | |

CONSTRUCTION KEYNOTES:

KEY	DESCRIPTION
C03	ONE SIDE GYP CENTRAL STUD, FRONT SIDE POLYGL FULL HEIGHT MECHANICALLY FIXED TO STUDS (REFER TO ELEVATION FOR MORE INFORMATION)
C04	PARTIAL HEIGHT GYP, WITH SECTION OF EXPOSED STUDS (REFER TO ELEVATION FOR MORE INFORMATION)
C05	GC TO ALLOW FOR RE LIGHTING OF GYPSUM IF IT DOES NOT CONTINUE PAST DEMO'D CEILING - PAINT
C08	COLUMN TO BE FURRED OUT.
C09	COLUMN TO BE FURRED OUT TO CEILING

CONSTRUCTION SYMBOLS LEGEND:

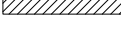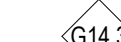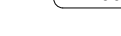	EXISTING WALL TO REMAIN, PROTECT IN PLACE
	NEW WALL PARTITIONS
	NEW MILLWORK
	NOT IN SCOPE
	PARTITION TAG
	DOOR TAG
	EQUIPMENT / PLUMBING FIXTURE TAG
	WINDOW TAG
	NEW CMU WALLS

OSHA APPROVED ROOF ACCESS LADDER TO BE PROVIDED. LOCATION TO BE DETERMINED.



hlw
1437 4th Street, 4th Floor
Santa Monica, California 90401
t +1 310 453 2800 | www.hlw.design

**IDG STRUCTURAL
ENGINEERING, INC.**
STRUCTURAL ENGINEER
10866 Wimer Country Road
Los Angeles, CA 91040
t +1 323 257-8854


ARC ENGINEERING
MEP ENGINEER
3045 N Hollywood Way, Burbank,
CA 91505
t +1 (818) 508-6300

SPARK
LIGHTING CONSULTANT
5 Penn Plaza, Level 5, New York,
NY 10001
t +1 212-353-4673


PLANNET
TELECOMMUNICATION CONSULTANT
Ten Pointe Drive, Suite 410
Brea, CA 92821
t +1 714.982.5800

NO.	DATE	ISSUE OR REVISION
A	03/17/2025	ISSUED FOR PLAN CHECK 1-PHASE 1
B	04/28/2025	ISSUED FOR PLAN CHECK 2-PHASE 1
D	06/27/2025	ISSUED FOR CONSTRUCTION - PHASE

KEY PLAN

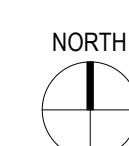

SEAL/ SIGNATURE

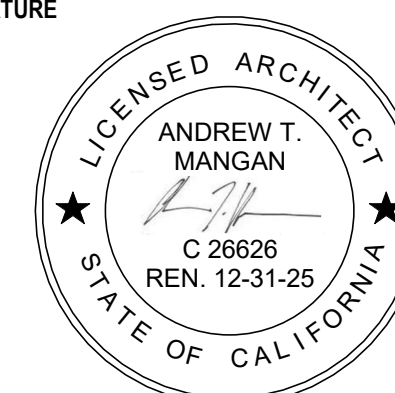

SHEET TITLE:

LEVEL 1 - FLOOR PLAN -
WEST


PROJECT NO.
24235

SCALE

QA BY

SHEET NO.

A-101

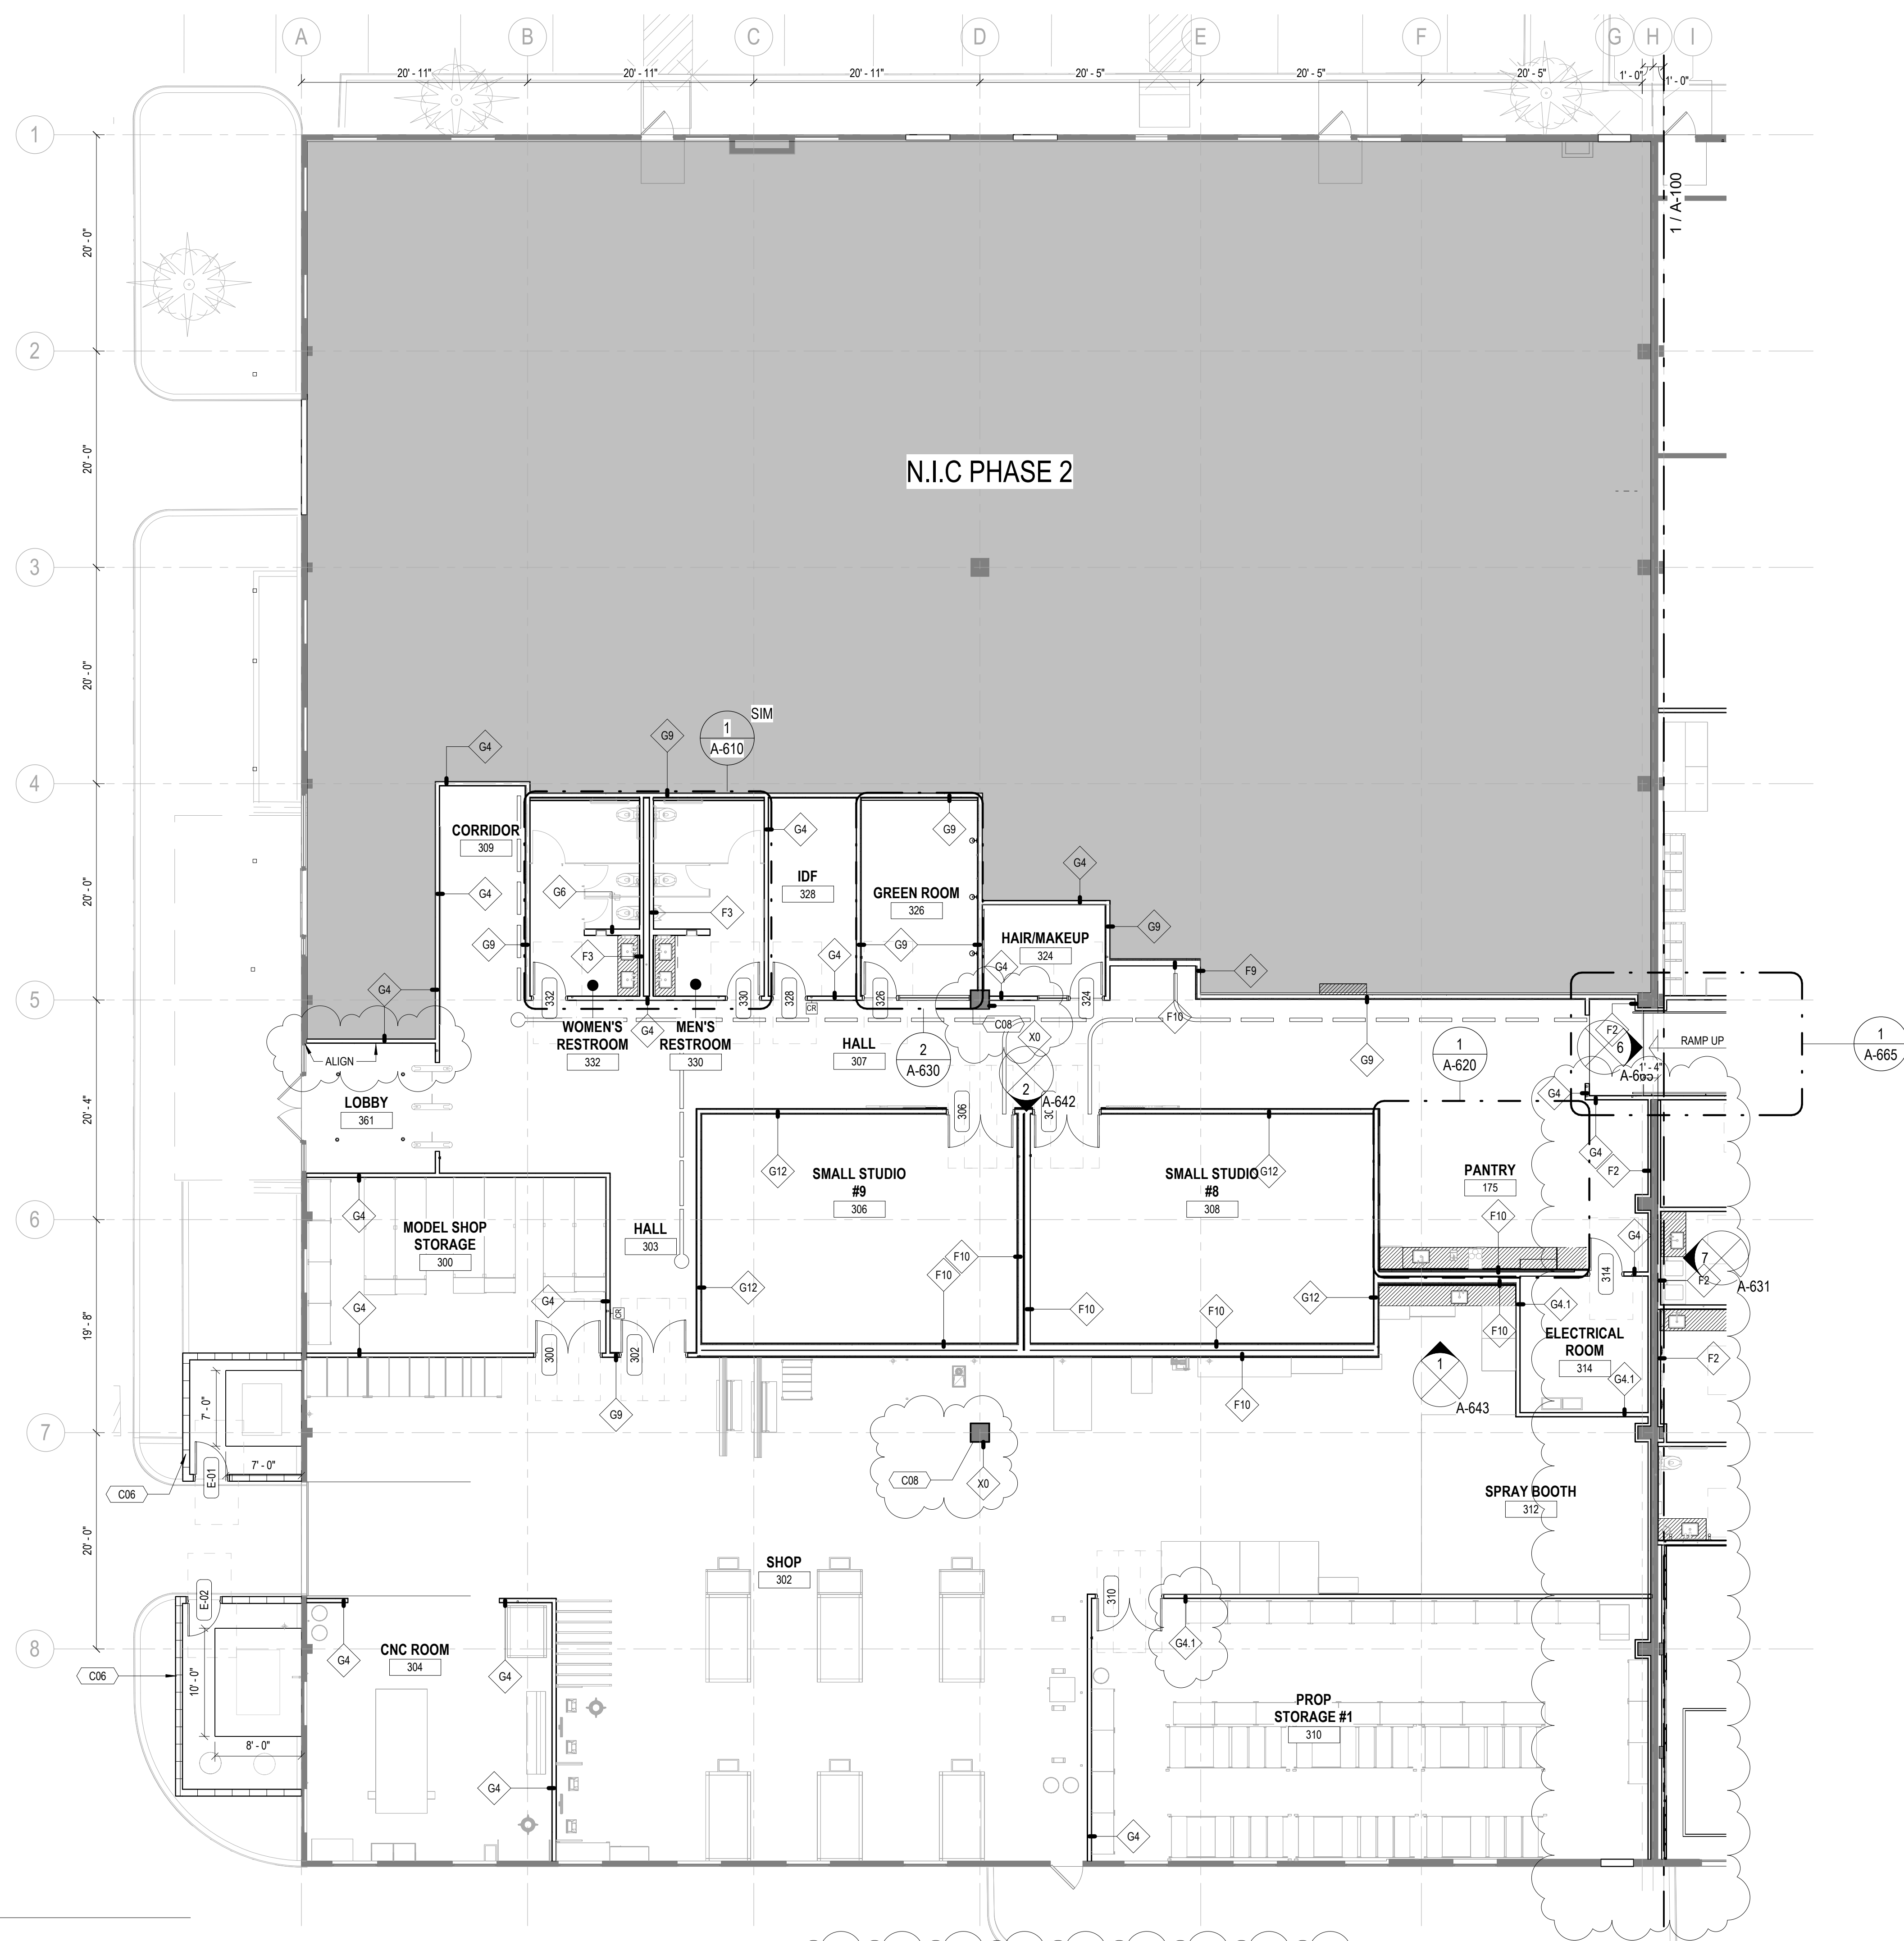

1 LEVEL 1 - CONSTRUCTION - WEST

CONSTRUCTION KEYNOTES:

KEY	DESCRIPTION
C06	NEW CMU EQUIPMENT ENCLOSURE. SEE STRUCTURAL DRAWINGS.
C08	COLUMN TO BE FURRED OUT.

CONSTRUCTION SYMBOLS LEGEND:

	EXISTING WALL TO REMAIN, PROTECT IN PLACE
	NEW WALL PARTITIONS
	NEW MILLWORK
	NOT IN SCOPE
	PARTITION TAG
	DOOR TAG
	EQUIPMENT / PLUMBING FIXTURE TAG
	WINDOW TAG
	NEW CMU WALLS

OSHA APPROVED ROOF ACCESS LADDER TO BE PROVIDED. LOCATION TO BE DETERMINED.

GENERAL CONSTRUCTION NOTES:

- | | |
|--|--|
| <p>THE TERM "FINISH FLOOR," WHERE INDICATED ON THE DRAWING, REFERS TO THE NORMAL FINISHED FLOOR LEVEL OF THAT FLOOR. HEIGHTS NOTED IN SCHEDULES ARE HEIGHTS ABOVE FINISH FLOOR, UNLESS OTHERWISE NOTED.</p> <p>ALL WALLS AND PARTITIONS ARE DIMENSIONED TO THEIR NOMINAL SIZES, UNLESS OTHERWISE NOTED. WHERE DIMENSIONS ARE NOTED AS "MINIMUM," THE MINIMUM DIMENSION IS TO BE MAINTAINED THROUGHOUT CONSTRUCTION.</p> <p>ALL DIMENSIONS ARE MEASURED FROM FINISH TO FINISH UNLESS OTHERWISE NOTED.</p> <p>ALL DIMENSIONS TO BE VERIFIED IN FIELD. ANY DISCREPANCIES SHALL BE BROUGHT TO THE ARCHITECT'S ATTENTION PRIOR TO COMMENCEMENT OF WORK.</p> <p>THE DISTANCE FROM DOOR DAMBS TO ADJACENT PARTITIONS SHALL NOT BE LESS THAN 4", UNLESS OTHERWISE NOTED OR APPROVED BY ARCHITECT.</p> <p>FOR LOCKS OF ADDITIONAL CLEAN OUT DOORS AND ACCESS DOORS IN PARTITIONS AND HUNG GLASSES NOT SHOWN ON PLANS, REFER TO THE MECHANICAL PLUMBING FIRE PROTECTION AND ELECTRICAL PLANS AND PROVIDE ACCESS DOORS AT LOCATIONS REQUIRING ACCESS TO MECHANICAL EQUIPMENT. THE ARCHITECT SHALL BE CONSULTED FOR FINAL LOCATIONS AND ACCESS DOOR SIZES.</p> <p>THE GENERAL CONTRACTOR SHALL FURNISH AND INSTALL ALL LINTELS, STRUTS, BRACKETS, HANGERS, ETC. WHEREVER NECESSARY TO SUPPORT STRUCTURE OR FINISHES. WHERE NECESSARY, THE GENERAL CONTRACTOR SHALL PROVIDE SUPPORT IN FIELD ALL ALIGNMENTS SHOWN IN DRAWINGS. IF ALIGNMENT IS NOT ACHIEVABLE, FURNISH COLUMN OR WALL TO PROVIDE ALIGNMENT.</p> <p>ALL EXTERIOR CORNERS AT GYPSUM WALLBOARD CONSTRUCTION SHALL BE METAL CORNER BEADS INSTALLED.</p> <p>ALL INTERIOR CORNERS AND DOOR AND WINDOW THRESHOLDS SHALL BE GYPSUM WALLBOARD CONSTRUCTION.</p> <p>AT ALL AREAS WHERE STRIPS ARE REQUIRED, THE VERTICAL AND HORIZONTAL SURFACES SHALL BE GYPSUM WALLBOARD, UNLESS OTHERWISE NOTED.</p> <p>AT ALL FINISHING STOPS ARE REQUIRED AT INTERIOR DOOR OPENINGS WHERE DIFFERENT TYPES OF FLOOR FINISHES OCCUR IN ADJOINING ROOMS, UNLESS OTHERWISE NOTED, WHERE ADJOINING ROOMS AND SPACES HAVE THE SAME KIND OF FLOOR COVERING OF DIFFERENT COLOR, EXTEND THE FLOOR COVERING THROUGH THE DOOR OPENING AND FINISH AT TRANSITION POINT.</p> <p>ALL VERTICAL PIPES AND DUCTS ARE TO BE FURRED OUT WITH MATERIALS TO MATCH ADJACENT SURFACES.</p> <p>ALL EQUIPMENT SECURED TO INTERIOR PARTITIONS SHALL BE FASTENED DIRECTLY TO METAL STUDS, PROVIDE METAL STRAPPING OR STEEL ANCHORS TO INTERIOR MOUNTED EQUIPMENT, CABINETS AND FUTURE TYPICALS AS SHOWN.</p> <p>ALL OPENINGS AT GYPSUM WALLBOARD PARTITIONS FOR DUCTS, ELECTRIC PANEL BOXES, ETC. ARE TO BE STEEL, STUD-FRAMED OPENINGS.</p> <p>ALL TEARS RECESS INTO RATED PARTITIONS (SUCH AS OUTLET BOXES, PANEL BOXES, ETC.) SHALL HAVE THOSE OPENINGS PROTECTED WITH BACK-UP MATERIALS SO AS TO RETAIN THE INTEGRITY OF THE PARTITION RATING THROUGHOUT. PROTECTION OF THESE OPENINGS SHALL BE IN STRICT CONFORMITY WITH THE BUILDING CODE, LOCAL ORDINANCES AND BE TO THE SATISFACTION OF THE LOCAL AUTHORITIES HAVING JURISDICTION.</p> | <p>ALL TEARS RECESS INTO RATED PARTITIONS (SUCH AS OUTLET BOXES, PANEL BOXES, ETC.) SHALL HAVE THOSE OPENINGS PROTECTED WITH BACK-UP MATERIALS SO AS TO RETAIN THE INTEGRITY OF THE PARTITION RATING THROUGHOUT. PROTECTION OF THESE OPENINGS SHALL BE IN STRICT CONFORMITY WITH THE BUILDING CODE, LOCAL ORDINANCES AND BE TO THE SATISFACTION OF THE LOCAL AUTHORITIES HAVING JURISDICTION.</p> <p>ALL EXISTING CONDITIONS NOT WITHIN SCOPE OF WORK TO BE PROTECTED OR RELOCATED THROUGHOUT THE DURATION OF WORK AND REPLACED UPON COMPLETION OF WORK. REFER TO ENGINEERS DRAWINGS FOR ADDITIONAL INFORMATION.</p> <p>DEMOLITION IS DEFINED AS REMOVAL IN EXCESS OF THAT REQUIRED FOR THE RESTORATION OF THE EXISTING TO ITS ORIGINAL CONDITION AT NO COST TO THE OWNER.</p> <p>ALL EXISTING SPRAYED FIRE RESISTANT MATERIALS TO BE MAINTAINED AND PROTECTED, PROVIDE SPRAYED FIREPROOFING TO MATCH EXISTING ADJACENT RATING AT AREAS AFFECTED BY, BUT NOT LIMITED TO, REMOVED PARTITIONS, PROVIDE SPRAYED FIREPROOFING TO ANY EXISTING EXPOSED STEEL, DECK, BEAM, AND COLUMNS AND ASSOCIATED COMPONENTS. REFER TO PROJECT MANUAL FOR ADDITIONAL INFORMATION.</p> <p>REFER TO DEMOLITION PLANS AND CONSTRUCTION PLANS FOR SPECIFIC EXTENT OF DEMOLITION AND ALL ADDITIONAL WORK.</p> <p>EXISTING FLOOR SLAB TO BE FLASH-PATCHED/LEVELLED AS REQUIRED TO PROVIDE A LEVEL AND CONSISTENT SURFACE TO RECEIVE SCHEDULED FINISHES. WHERE STONE IS REMOVED, DO NOT CUT TO ENSURE ALL REMEDIAL WORK AS REQUIRED TO COVER EXISTING FINISHES.</p> <p>PROVIDE FIRE RETARDANT IN-WALL BLOCKING FOR ALL WALL MOUNTED TYPICALS, GLASS MARKER BOARDS, AND MILLWORK.</p> <p>PROVIDE FIRE RETARDANT IN-WALL BLOCKING FOR ALL WALL MOUNTED TYPICALS.</p> <p>PROVIDE FIRE RETARDANT IN-WALL BLOCKING FOR ALL WALL MOUNTED TYPICALS CONTRACTOR TO COORDINATE FINAL LOCATIONS AND MOUNTING HEIGHTS WITH AV DRAWINGS.</p> <p>ADJUSTOR TO FIRE STOP ALL PENETRATIONS THROUGH RATED ASSEMBLIES, TYP.</p> <p>PROVIDE PORTABLE FIRE EXTINGUISHER WITH A RATING OF NOT LESS THAN 2A OR 2A10BC WITH 75' TRAVEL DISTANCE, TO ALL PORTIONS OF THE BUILDING ON EACH FLOOR; ALSO DURING CONSTRUCTION, ALL NEW FIRE EXTINGUISHER CABINETS SHOULD BE RECESSED AND SECURED TO INTERIOR PARTITIONS TO MATCH ADJACENT SURFACES.</p> <p>ALL EXISTING PERIMETER WINDOW SHADE ENCLOSURES TO REMAIN AND BE PROTECTED THROUGHOUT CONSTRUCTION, UNLESS OTHERWISE NOTED. PROVIDE NEW SHADES AS PER FINISH PLANS AND SCHEDULE.</p> |
|--|--|

- ALL ITEMS RECESSED INTO DEEPER PARTITIONS (SUCH AS OUTLET BOXES, PANEL BOXES, ETC.) SHALL HAVE THOSE OPENINGS PROTECTED WITH BACK-UP MATERIALS SO AS TO RETAIN THE INTEGRITY OF THE PARTITION RATING THROUGHOUT. PROTECTION OF THESE OPENINGS SHALL BE IN STRICT CONFORMITY WITH THE BUILDING CODE, LOCAL ORDINANCES AND BE TO THE SATISFACTION OF THE CITY OF CHICAGO AND THE CHICAGO FIRE DEPARTMENT. DRAWINGS SHALL BE CONSIDERED TO BE SUPPLEMENTAL TO THE SPECIFICATIONS.
14. ALL EXISTING CONDITIONS NOT WITHIN SCOPE OF WORK TO BE PROTECTED OR RELOCATED THROUGHOUT THE DURATION OF WORK AND REPLACED UPON COMPLETION OF WORK. REFER TO ENGINEER'S DRAWINGS FOR ADDITIONAL INFORMATION. CONTRACTOR SHALL PERFORM ALL WORK AS REQUIRED, INCLUDING CONTRACTOR TO RESTORE TO PROTECTED AREAS TO THE ORIGINAL CONDITION AT NO COST TO THE OWNER.
15. ALL EXISTING SPRAYED FIRE RESISTANT MATERIALS TO BE MAINTAINED AND PROTECTED. PROVIDE SPRAYED FIREPROOFING TO ANY EXISTING EXPOSED STEEL, DECK, BEAM, AND COLUMNS AND ASSOCIATED COMPONENTS. REFER TO PROJECT MANUAL FOR ADDITIONAL INFORMATION.
16. EXISTING FLOOR SLABS TO BE FLASH-PATCHED/LEVELLED AS REQUIRED TO PROVIDE A LEVEL AND CONSISTENT SURFACE TO RECEIVE SCHEDULED FINISHES. WHERE STONE IS REMOVED, GO TO ENSURE ALL REMEDIAL WORK AS REQUIRED TO COVER SCREED.
17. PROVIDE FIRE RETARDANT IN-FLAME BLOCKING FOR ALL WALL MOUNTED FINISHES, GLASS MARKER BOARDS, AND MILLWORK. CONTRACTOR TO COORDINATE WITH FURNITURE VENDOR FOR FINAL CONNECTIONS.
18. PROVIDE FIRE RETARDANT IN-FLAME BLOCKING FOR ALL WALL MOUNTED TYPES. CONTRACTOR TO COORD W/ATE FINAL CONNECTIONS AND MOUNTING HEIGHTS WITH AV DRAWINGS.
19. CONTRACTOR TO FIRE STOP ALL PENETRATIONS THROUGH RATE ASSEMBLIES, TYP. CONTRACTOR TO PROVIDE 2"X4"X8" TRAVEL DISTANCE TO ALL PORTIONS OF THE BUILDING ON EACH FLOOR; ALSO DURING CONSTRUCTION, ALL NEW FIRE EXTINGUISHER CABINETS SHALL BE FULLY RECESSED AND TO BE PAINTED TO MATCH ADJACENT FINISHES, UNLESS OTHERWISE NOTED.
20. PROVIDE FIRE RETARDANT WOODSHPER ADHESIVES TO REMEDIAL FLASHING THROUGHOUT CONSTRUCTION; UNLESS OTHERWISE NOTED, PROVIDE NEW SHAPES AS REQUIRED AND SCHEDULE.